

PIPELINE COMMODITY MOVEMENT MAP


QUARTER 1, 2020

COMMODITY CLASSIFICATION LEGEND

NGL	(TO 599 kg/m³)
CONDENSATE / REFINED PRODUCTS	(600 - 799 kg/m³)
LIGHT CRUDE	(800 - 875 kg/m³)
MEDIUM CRUDE	(876 - 903 kg/m³)
HEAVY CRUDE	(904 - 940 kg/m³)

COMMODITY MOVEMENT LEGEND

	INJECTION
	DELIVERY
	DELIVERY/INJECTION

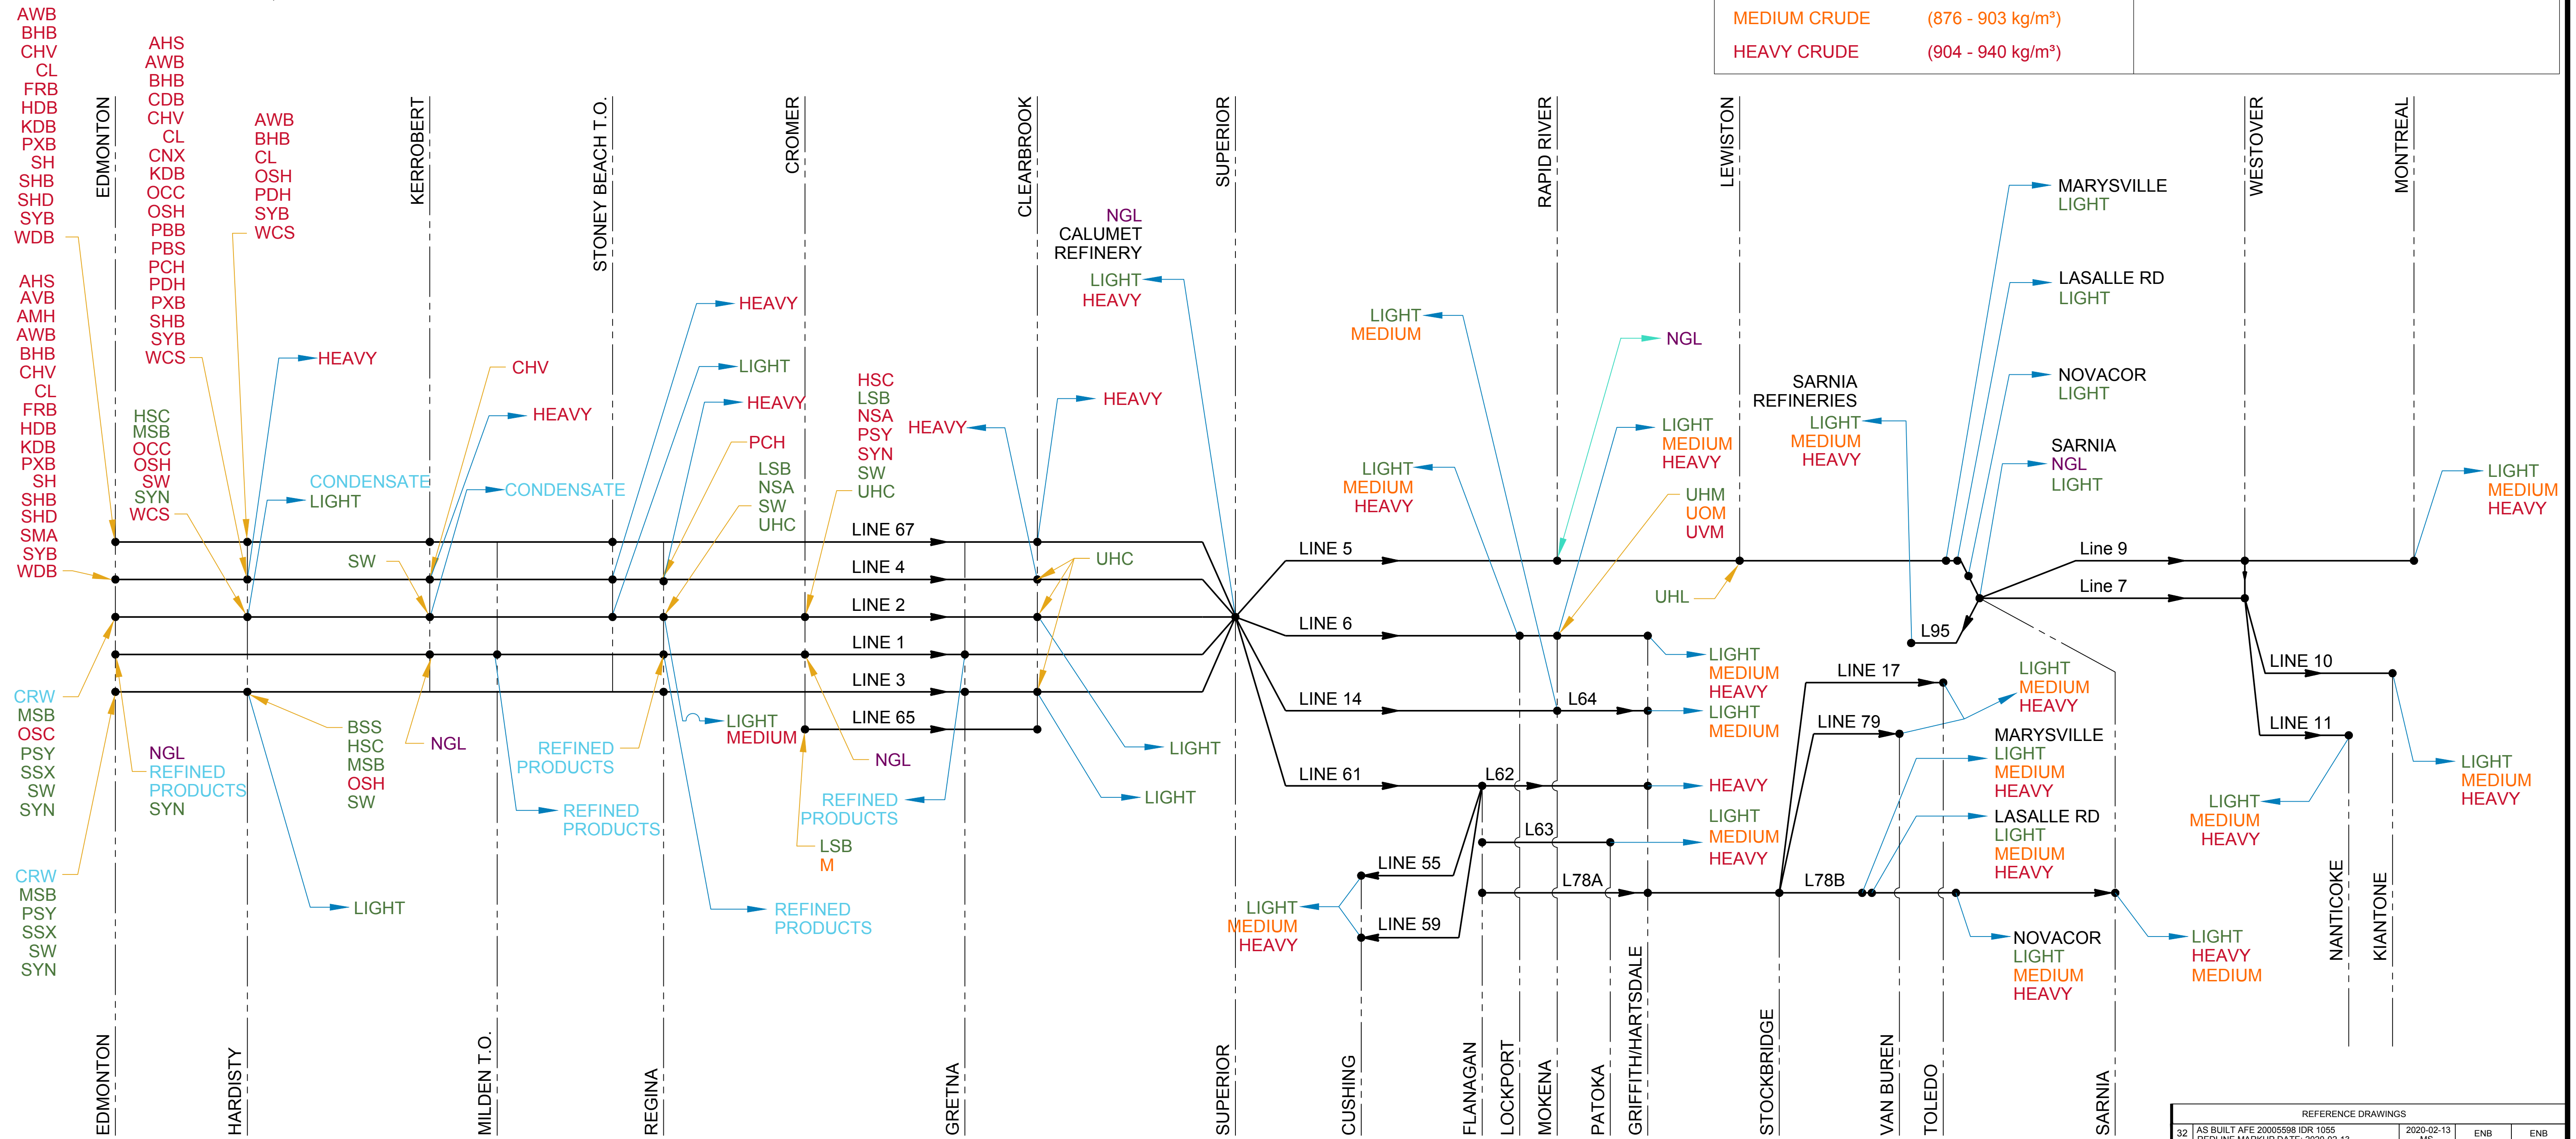

COMMODITY IDENTIFIER / CRUDE NAME LEGEND

AHS	ALBIAN HEAVY SYNTHETIC	CL	COLD LAKE	NSA	NEWGRADE SYNTHETIC BLEND A	SHB	SURMONT HEAVY BLEND	UVM	U.S. HEAVY - MOKENA		
AMH	ALBIAN MUSKEG RIVER HEAVY	CNX	CONDENSATE BLEND	OCC	SUNCOR - CUSTOM CRACKED	SHD	SURMONT HEAVY DILBIT	WCS	WESTERN CANADIAN SELECT		
AVB	ALBIAN VACUUM GAS OIL BLEND	CRW	CONDENSATE BLEND	OSC	SUNCOR LIGHT SYNTHETIC	SMA	SURMONT MIX A	WDB	WESTERN CANADIAN DILBIT		
AWB	ACCESS WESTERN BLEND	FRB	FORT HILLS REDUCED CARBON LIFE CYCLE DILBIT BLEND	OSH	SUNCOR - H	SSX	SHELL SYNTHETIC BLEND				
BHB	BOREALIS HEAVY BLEND	HDB	HANGINGSTONE DILBIT BLEND	PBB	PINE BLEND BUFFER	SW	MIXED BLEND SWEET				
BSS	BP SWEET SYNTHETIC BLEND	HSC	HARDISTY SYNTHETIC CRUDE	PBS	PINE BLEND SPECIAL	SYB	SYNTHETIC BITUMEN BLEND				
CDB	CHRISTINA LAKE DILBIT BLEND	KDB	KEARL DILBIT	PCH	PREMIUM CONVENTIONAL HEAVY	SYN	SYNCRUDE				
CHV	CONVENTIONAL HEAVY	LSB	LIGHT SOUR BLEND	PDH	LONGLAKE HEAVY DILBIT BLEND	UHC	US HIGH SWEET				
CHS	CANADIAN HEAVY SWEET	M	MIDALE BLEND	PSY	PREMIUM SYNTHETIC	UHL	U.S. HIGH SWEET - LEWISTON				
CHT	CANADIAN HEAVY DILBIT	MSB	MEDIUM SOUR BLEND	PXB	PETRO CHINA BLEND	UHM	U.S. HIGH SWEET - MOKENA				
CHY	CANADIAN HEAVY SYNBIT	NGL	NATURAL GAS LIQUIDS	SH	SEAL HEAVY	UOM	U.S. HIGH SOUR MOKENA				

REFERENCE DRAWINGS				
32	AS BUILT AFE 20005588 IDR 1055	2020-02-13	ENB	ENB
31	REDLINE MARKUP DATE: 2020-02-13	MS	BB	BB
30	REVISOR AS PER PIPELINE COMMODITY MAPS MARK UP DRAWING	2018-05-03	SH	SH
29	REVISOR AS PER PIPELINE COMMODITY MAPS MARK UP DRAWING	2017-01-24	SKE/KP	SKE/KP
28	REVISOR AS PER PIPELINE COMMODITY MAPS MARK UP DRAWING	2017-01-09	SKE/AE	SKE/AE
27	REVISOR AS PER SCHEDULING OPTIMIZATION Q1 INFO	2016-01-19	DRD/RB	DRD/RB
REV NO.	REVISION DESCRIPTION	DATE BY	CHK	APPR

COPYRIGHT © THIS DRAWING IS THE PROPERTY OF ENBRIDGE AND SHALL NOT BE REPRODUCED EITHER IN WHOLE OR IN PART WITHOUT PRIOR WRITTEN CONSENT OF ENBRIDGE.



ENBRIDGE PIPELINES INC.
COMMODITY MOVEMENT MAP

BY:AMJ	CHK: CAL	ENG.: PBONTKES/DB	ENB APPR: EGH
DATE: 2000-05-17	SCALE: NTS	STATUS: AS BUILDING	

DWG NO.: D-0.0-1812-0	REV NO.: 32.A
-----------------------	---------------